


NE SOUTH VILLA DRIVE

10' "NO-BUILD ZONE"

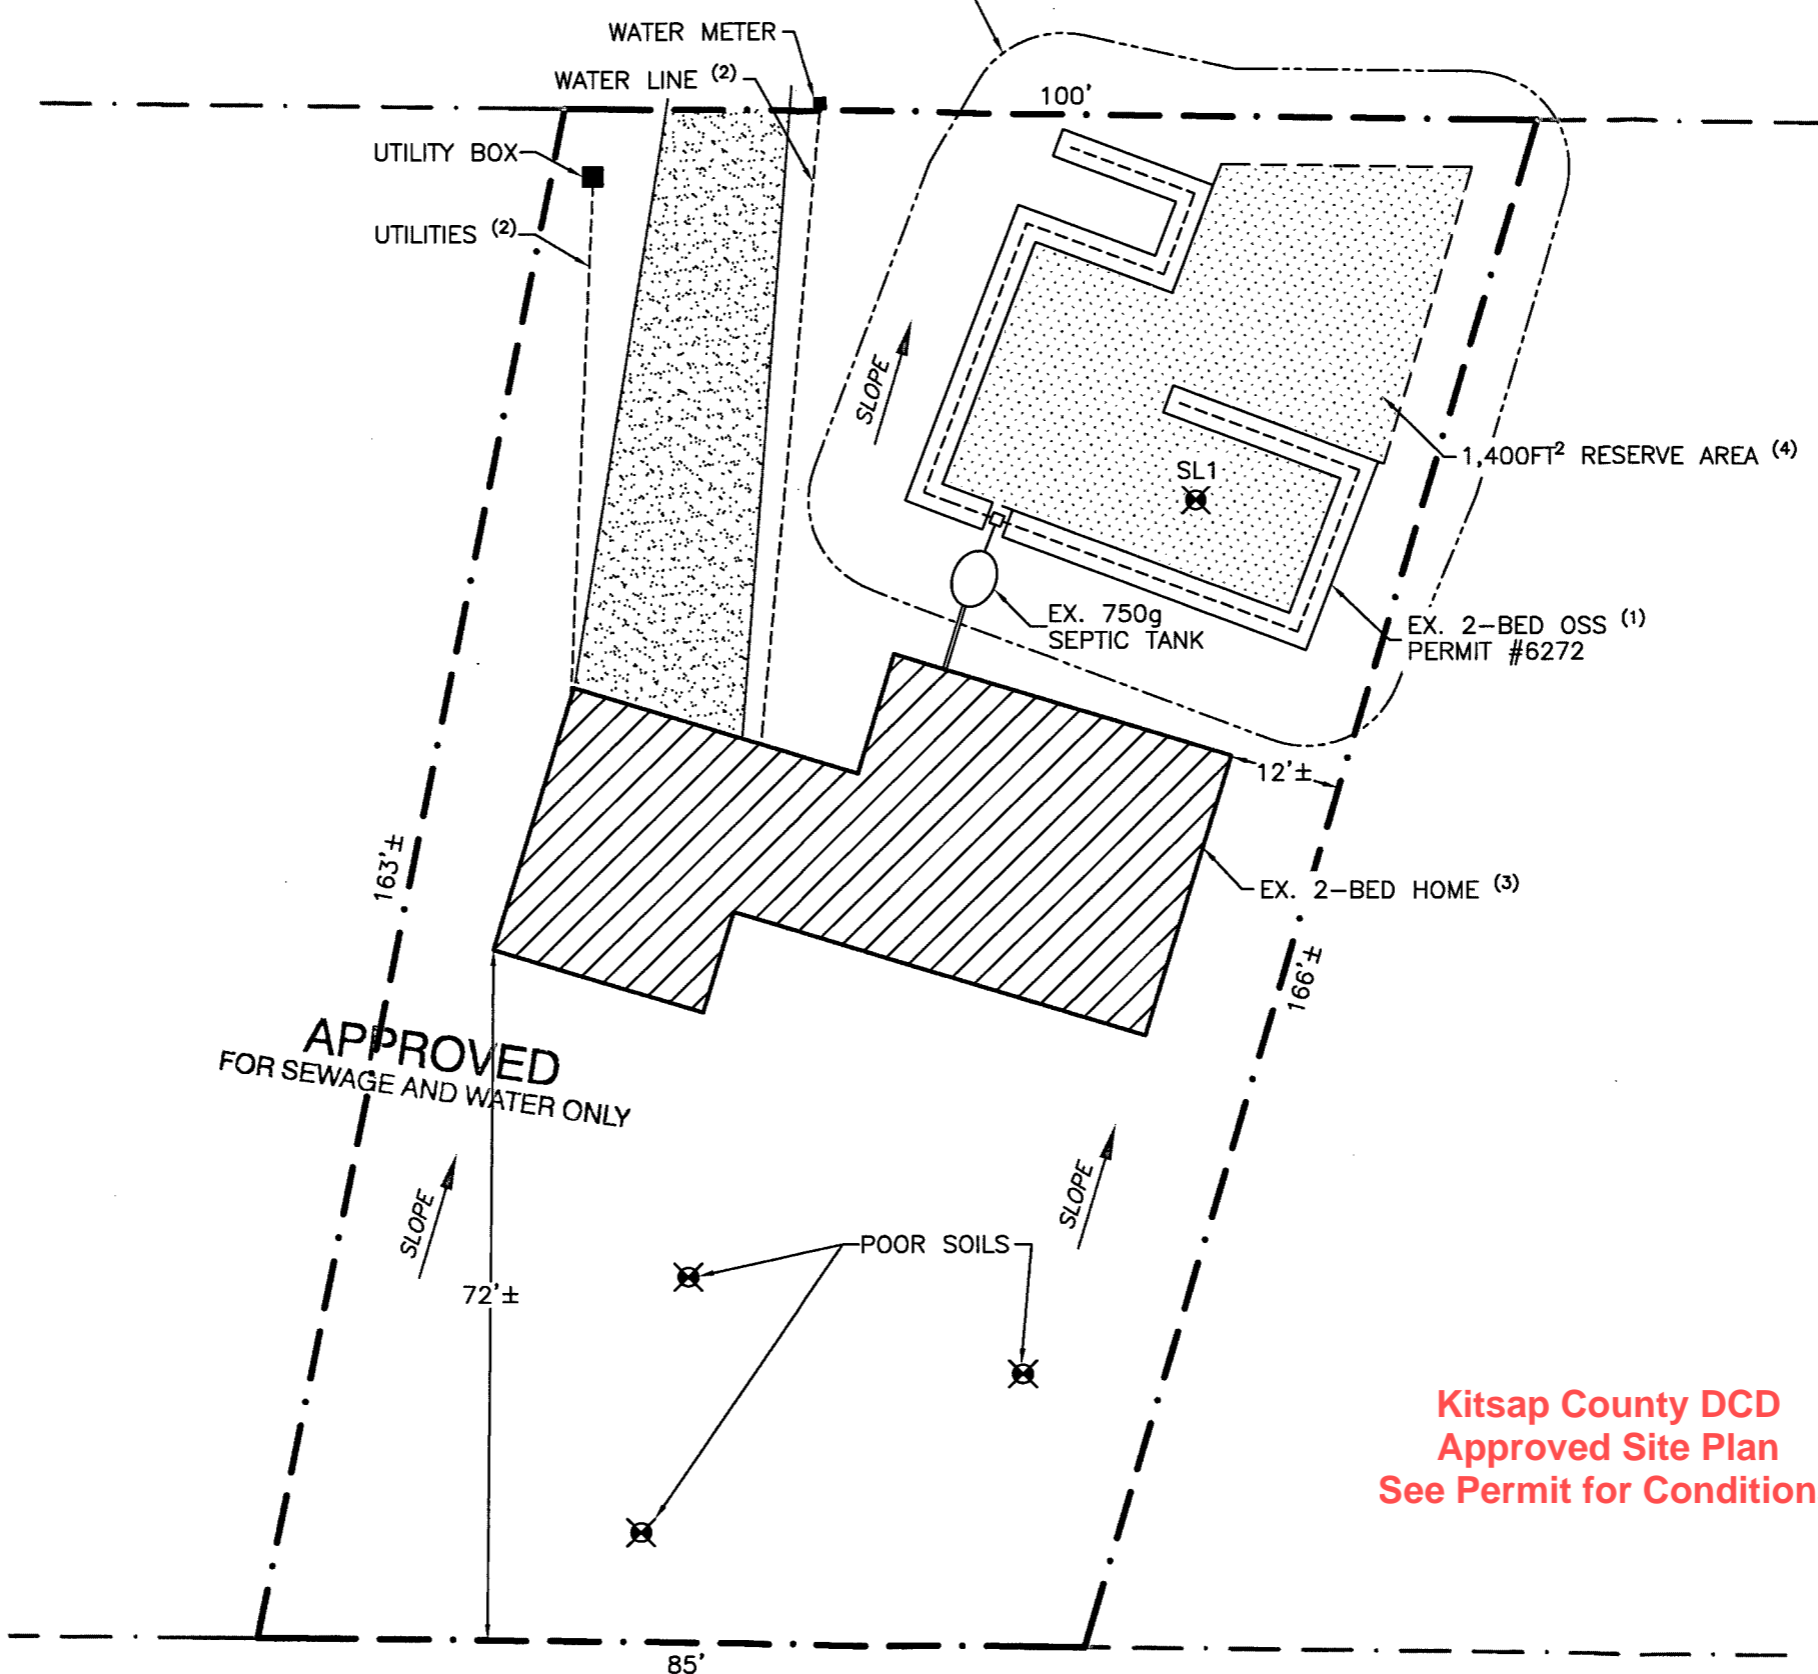

PLAN - DETAIL

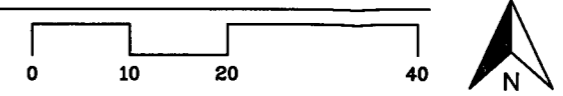


Figure 1: Site Plan Requirements Checklist

All site plans shall be clearly and accurately drawn to 1"=20', 30', 40' or 50' scale on paper no larger than 11" x 17" and must indicate all of the following information. For each item below, mark either "Shown" or "N/A" as appropriate for your project. This checklist must be completed and included on all site plans. Any site plan without this checklist will be rejected and returned to the applicant for correction.

Shown	Parcel Number
N/A	
A General Property Information:	
<input checked="" type="checkbox"/>	Tax ID Number and Property Address
<input checked="" type="checkbox"/>	Property lines and dimensions
<input checked="" type="checkbox"/>	Elevations of property and the direction of natural drainage
<input checked="" type="checkbox"/>	Slopes that exceed 15%, including any cut banks greater than 4' in height
<input checked="" type="checkbox"/>	North arrow and site plan scale
<input type="checkbox"/>	Marine waters, lakes and ponds and their associated high water lines
<input type="checkbox"/>	Streams, creeks & wetlands and their associated buffer areas
B Existing Property Improvements:	
<input type="checkbox"/>	Location of all existing structures, including the locations of existing structures on adjacent waterfront properties
<input checked="" type="checkbox"/>	Location of all existing wells and their well radii, including those wells on adjacent properties within 100' of property lines
<input checked="" type="checkbox"/>	Location of all existing drainfields, including the 10' "No Build Zone" as well as the locations of existing drainfields on adjacent properties within 100' of any well
<input type="checkbox"/>	Location of existing drainage facilities, including all sub-surface infiltration systems
<input type="checkbox"/>	Location of all existing and abutting roadways, driveways, easements, buffers and required open spaces
<input type="checkbox"/>	Location of all existing water, sewer and utility lines.
C Proposed Property Improvements:	
<input type="checkbox"/>	Location and dimensions of all proposed structures or building envelopes in relation to property lines, other structures, etc.
<input type="checkbox"/>	Location of all proposed wells, including their 100' well radii and all water lines
<input type="checkbox"/>	Location of all proposed septic tanks, pump tanks, pre-treatment units, and drainfields, including the 10' "no build" zone
<input type="checkbox"/>	Location and dimensions of all proposed drainage and infiltration systems (I-Pits)
<input type="checkbox"/>	Location, dimensions, surfacing materials, and clearing limits of all proposed parking areas, driveways, sidewalks, & road app'r's.
<input type="checkbox"/>	Location of all proposed water, sewer and utility lines.

NOTES

1. EXISTING PRIMARY DRAIN FIELD SHOWN PER AS-BUILT INFORMATION. NOT LOCATED ELECTRONICALLY BY INDIGO DESIGN.
2. UNDERGROUND UTILITY LINE LOCATIONS ASSUMED.
3. PROPOSED REMODEL OF EXISTING 2-BEDROOM HOME. EXISTING FOOTPRINT TO REMAIN UNCHANGED. NO ADDITIONAL BEDROOMS PROPOSED.
4. PROPOSING RESERVE AREA IN-BETWEEN THE EXISTING PRIMARY DRAIN FIELD TRENCHES. SOILS OBSERVED IN THE BACKYARD AREA WERE INADEQUATE FOR AN OSS.

Permit Number: 19-01639

CLIENT:
CHRYSLIS REAL ESTATE SOLUTIONS

TAX ID. #
4385-000-009-0008


SITE ADDRESS:
12239 NE SOUTH VILLA DR
KINGSTON, WA 98346

SHEET ID:
S-02

RECEIVED
KITSAP PUBLIC HEALTH DISTRICT

REVISIONS:

INDIGO DESIGN INC.
P.O. BOX 163
POULSBORO, WASHINGTON 98370
360-779-5233

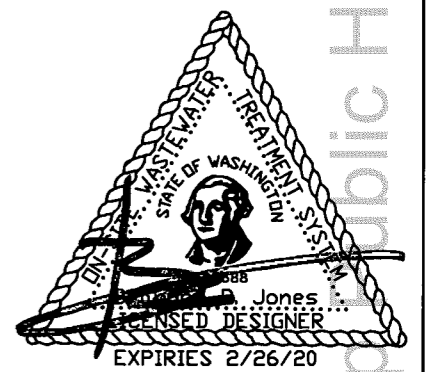

SHEET # 4 OF 4 SHEETS